

Republic of the Philippines
NATIONAL ACADEMY OF SCIENCE AND TECHNOLOGY
3rd Level Science Heritage Building, DOST Compound,
Bicutan, Taguig City
Tel. nos.: 837-2071 loc. 2171; Fax: 837-3170
Website: www.nast.ph
Email: nast.bac@gmail.com

SUPPLEMENTAL/BID BULLETIN No. 1

This Supplemental/Bid Bulletin is issued to inform prospective bidders of the project “Retiling of NAST-PSHC Lobby” of the following:


1. The deadline for the submission of bids is moved from 9:00 AM to 10:00 AM of March 15, 2016;
2. The opening of bids is moved from 9:30 AM to 10:30 AM of March 15, 2016;
3. Amendment to the Bid Documents are:
 - a. Page 68, item no. 1.27 – The start date is seven (7) days after the receipt of Notice to Proceed;
 - b. Page 69, item no. 31.1 – The contractor shall submit the Program of Works to the Procuring Entity’s Representative within seven (7) days after receipt of Notice to Proceed;
 - c. Page 69, item no. 31.3 – The amount to be withheld for late submission of an updated Program of Work is 10% of billed amount of Progress Billing.
 - d. Pages 35, item no. 18.1 – include “4. Bid Securing Declaration”
 - e. Page 35, item no. 13.1 – The financial component of the bid shall contain the Financial Bid Form and the detailed Bill of Quantities.
4. The As-Built Plan (Sanitary & Storm Drainage System Layout) of the Ground Floor of the Heritage Center is attached.

This bulletin shall form an integral part of the Bid Documents for the said project.

For guidance and information of all concerned.


GUADA B. RAMOS-DIMAYA
Chair, NAST BAC

March 4, 2016

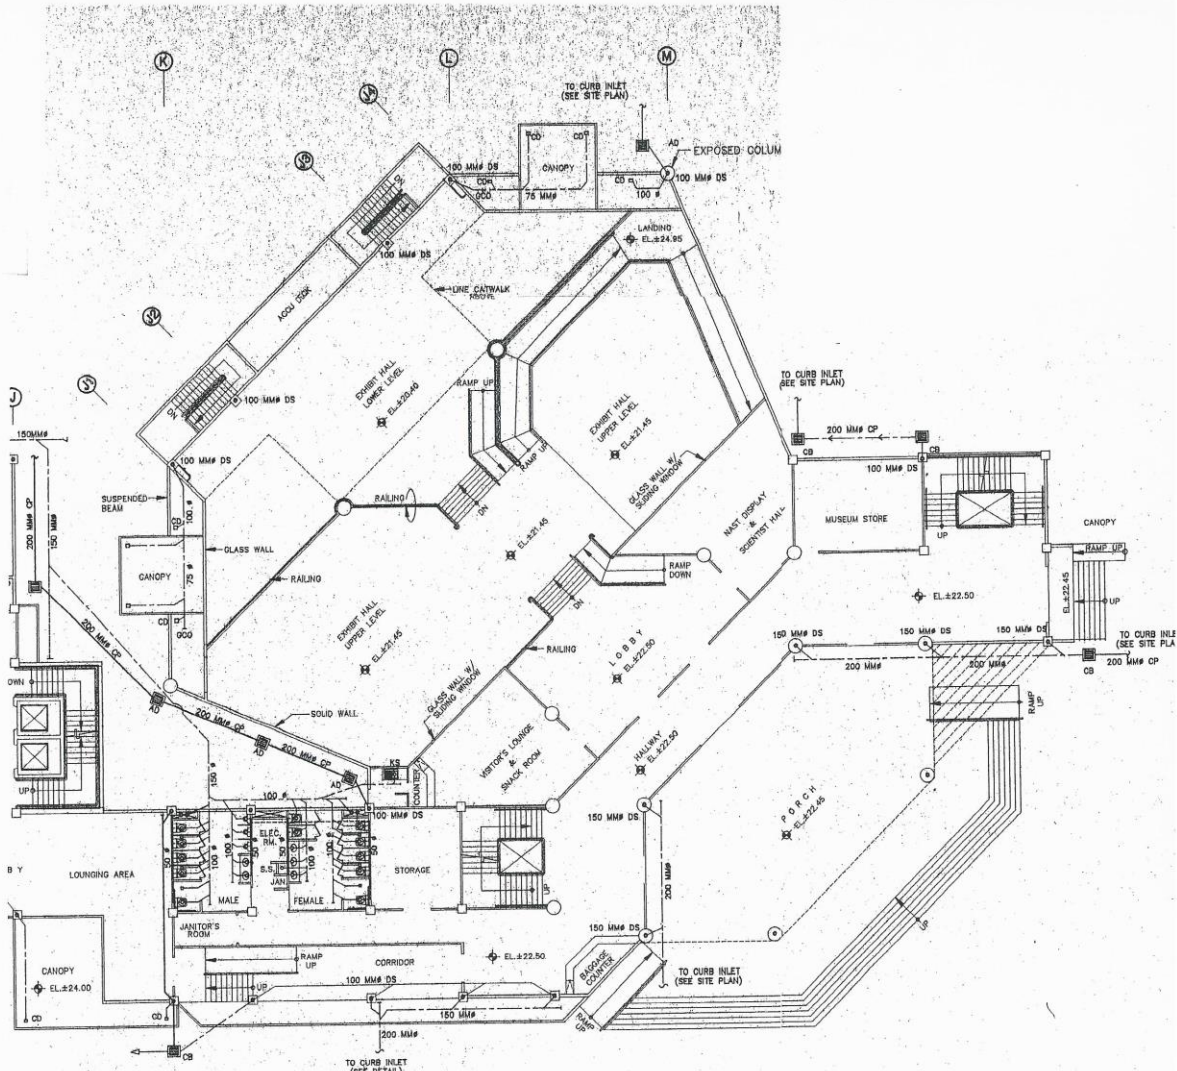

**GROUND FLOOR (HERITAGE CENTER)
SANITARY & STORM DRAINAGE SYSTEM LAYOUT**
SCALE 1:150 METERS

SOIL/SEWER LINE PIPING
STORM DRAINAGE CONCRETE PIPING

/ SEI / NRCP BUILDING (AS-BUILT) Republic of the Philippines PARTMENT OF SCIENCE AND TECHNOLOGY 301, SANTOS AVE., BOSTIAN TARRA, METRO MANILA	PREPARED BY FINANCIAL BUILDING CORP.	CHECKED BY SCHEMA KONSULT INC.	SHEET CONTENTS SECOND FLOOR: (NRCP OFFICES) - SANITARY & STORM DRAINAGE SYSTEM LAYOUT GROUND FLOOR: (HERITAGE CENTER) - SANITARY & STORM DRAINAGE SYSTEM LAYOUT	SHEET NUMBER D-5
	AS-BUILT PLAN			